


FACE PLATE


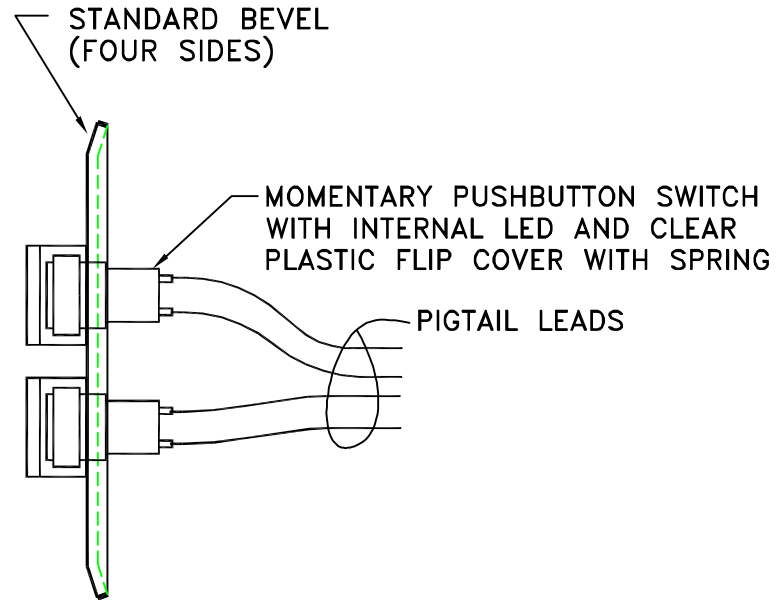


SIDE

EXTRUSION FOR #6 OVAL HEAD SCREW (2)

NOTES:

1. MATERIAL: .045" STAINLESS STEEL
2. FINISH: PASSIVATED

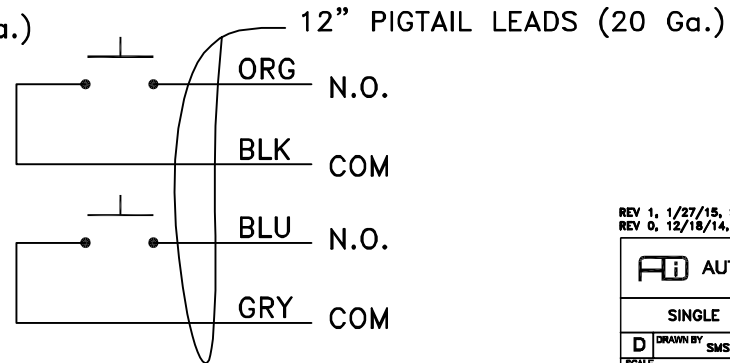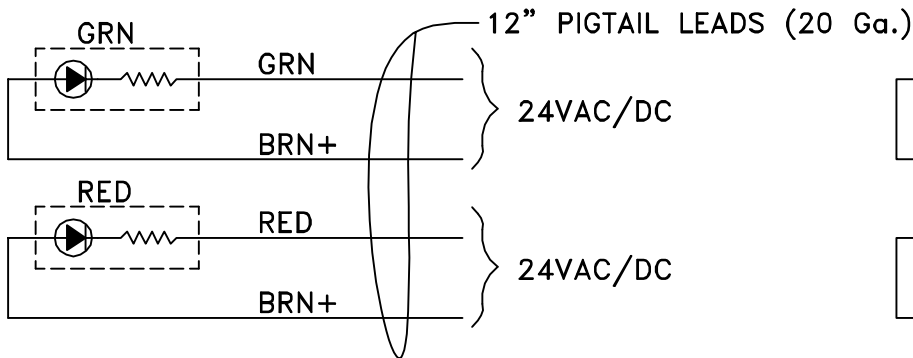

REV 1, 1/27/15, SMS, AS BUILT
REV 0, 12/18/14, SMS, OLD DRAWING #P135B-200

AD AUTOMATION DISPLAYS INC.			
SINGLE GANG PLATE WITH 2 BUTTONS			
D	DRAWN BY SMS	PART #AFD-P135A1	
SCALE	DATE 12/18/14	REV. NO. 1	DRAWING NO. SERA-P135A1